

UNOFFICIAL COPY

THIS DOCUMENT WAS PREPARED BY:

Klein Thorpe & Jenkins, Ltd.
20 North Wacker Drive, Suite 1660
Chicago, IL 60606
Michael A. Marrs

AFTER RECORDING RETURN TO:

Cook County: Recorders Box 324 (MAM)

Will County:
Klein Thorpe & Jenkins, Ltd.
20 North Wacker Drive, Suite 1660
Chicago, IL 60606
Attn: Michael A. Marrs



Doc#: 0526339116 Fee: \$30.00
Eugene "Gene" Moore
Cook County Recorder of Deeds
Date: 09/20/2005 03:25 PM Pg: 1 of 4

[The above space for recording purposes]

RIGHT-OF-WAY ENCROACHMENT WAIVER AND AGREEMENT

RE: Proposed Public Right-of-Way use for brick paver/decorative concrete/asphalt driveway approach/brick mailboxes/lawn sprinkler heads/decorative landscaping and/or proposed easement encroachment for pool/deck/fence/shed/retaining wall/patio and/or service walk.

I/We, WILLIAM P. BRADY + BETTE J. BRADY, represent that we are the legal owners of real property commonly known as:

8701 RADCLIFFE RD, Tinley Park, Illinois 60477.
insert property address

PIN(S) #: 27-35-110-011-0000

(Survey of property containing legal description of said property is attached and made a part hereof as "EXHIBIT A")

I/We are undertaking the following Project at the above stated Property that will encroach on the Public Right-of-Way:

Project: LAWN SPRINKLER

I/We understand that the Village Code does not allow for the construction of a driveway in the public right-of-way surfaced with any material other than concrete or asphalt. I/We agree that the driveway to be constructed in the public right-of-way at the above address out of brick paver/decorative concrete/embossed or colored asphalt will be my responsibility to maintain, repair, and replace if necessary, due to any damage by the Village or other public agencies, or due to normal wear and tear.

I/We further understand that, on streets without curbs, the decorative drive must end no less than two feet from the edge of existing pavement.

UNOFFICIAL COPY

I/We understand that the Village will allow the construction of a pool/deck/fence/shed/retaining wall/patio and/or service walk encroaching upon an easement to require the written permission of each utility affected by the subject construction.

I/We agree that the pool/deck/fence/shed/retaining wall/patio and/or service walk encroaching upon the easement at the above address, will be my responsibility to maintain, repair, and replace if necessary, due to any damage by the Village or other public agencies, or due to normal wear and tear.

I/We also understand Village Codes do not permit any obstructions in the Public Right-of-Way and that any lawn sprinkler systems, brick mailboxes, decorative landscaping placed upon the public right-of-way will be my responsibility to maintain, repair, and replace if necessary, due to any damage by the Village or other public agencies, or due to normal wear and tear.

I/We covenant and agree that all construction taking place on the Project will be in accordance with the Village Building Codes.

I/We also understand that as a condition of the Village of Tinley Park granting permission to utilize the public right-of-way abutting the Subject Property and/or easement encroachment for the aforesaid purposes, the undersigned owner(s) covenants and agrees not to sue and to protect, indemnify, defend, and hold harmless the Village of Tinley Park against any and all claims, costs, actions, losses, demands, injuries and expenses of whatever nature ("Claims"), including, but not limited to attorneys' fees, on such uses being located in the public right-of-way and/or easement encroachment and/or from acts or omissions by the undersigned owner, its contractors, sub contractors, or agents or employees in maintaining the same and/or in conjunction with the use of the public right-of-way abutting the Subject Property and/or easement encroachment for the aforesaid purposes.

I/We understand that the terms and conditions contained herein apply uniquely to the Public Right-of-Way and Easements of the property at the above address as legally described in Exhibit A and it is the intent of myself and the Village to have the terms and conditions of this instrument run with the land and be binding on subsequent purchasers.

This document shall be notarized and recorded with the Cook/Will County Recorder of Deeds.

NOTE: ALL OWNERS MUST SIGN

X William P. Brady
Homeowner Signature

X Bette J. Brady
Homeowner Signature (if more than one)

X Date: 7-25-05


X Date: 8-17-05

NOTARY: STATE OF ILLINOIS, COUNTY OF Cook) SS

I, BRAD L. BETTENHAUSEN, a Notary Public in Cook County, in the State of Illinois, do hereby certify that WILLIAM & BETTE BRADY, were personally known to me to be the same person(s) whose name(s) is/are here subscribed to the foregoing instrument, appeared before me this day in person and acknowledged that he/she/they signed, sealed, and delivered said instrument as his/her/their free and voluntary act for the uses and purposes therein set forth. Given under my hand and notarial seal this 17th day of AUGUST, 2005.

Notary Signature: Brad L. Bettenhausen


[SEAL]

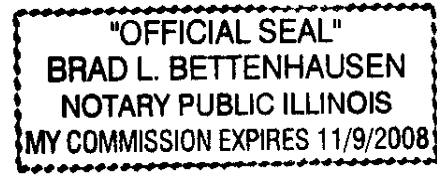

UNOFFICIAL COPY

PLAT OF SURVEY

LOT 117, IN GALLAGHER & HENRY'S RADCLIFFE PLACE UNIT 4, A SUBDIVISION OF PART OF THE NORTHWEST QUARTER OF SECTION 35, IN TOWNSHIP 36 NORTH, RANGE 12 EAST OF THE THIRD PRINCIPAL MERIDIAN, ACCORDING TO THE PLAT THEREOF RECORDED JANUARY 29, 2001, AS DOCUMENT NO. 0010073723, IN COOK COUNTY, ILLINOIS.

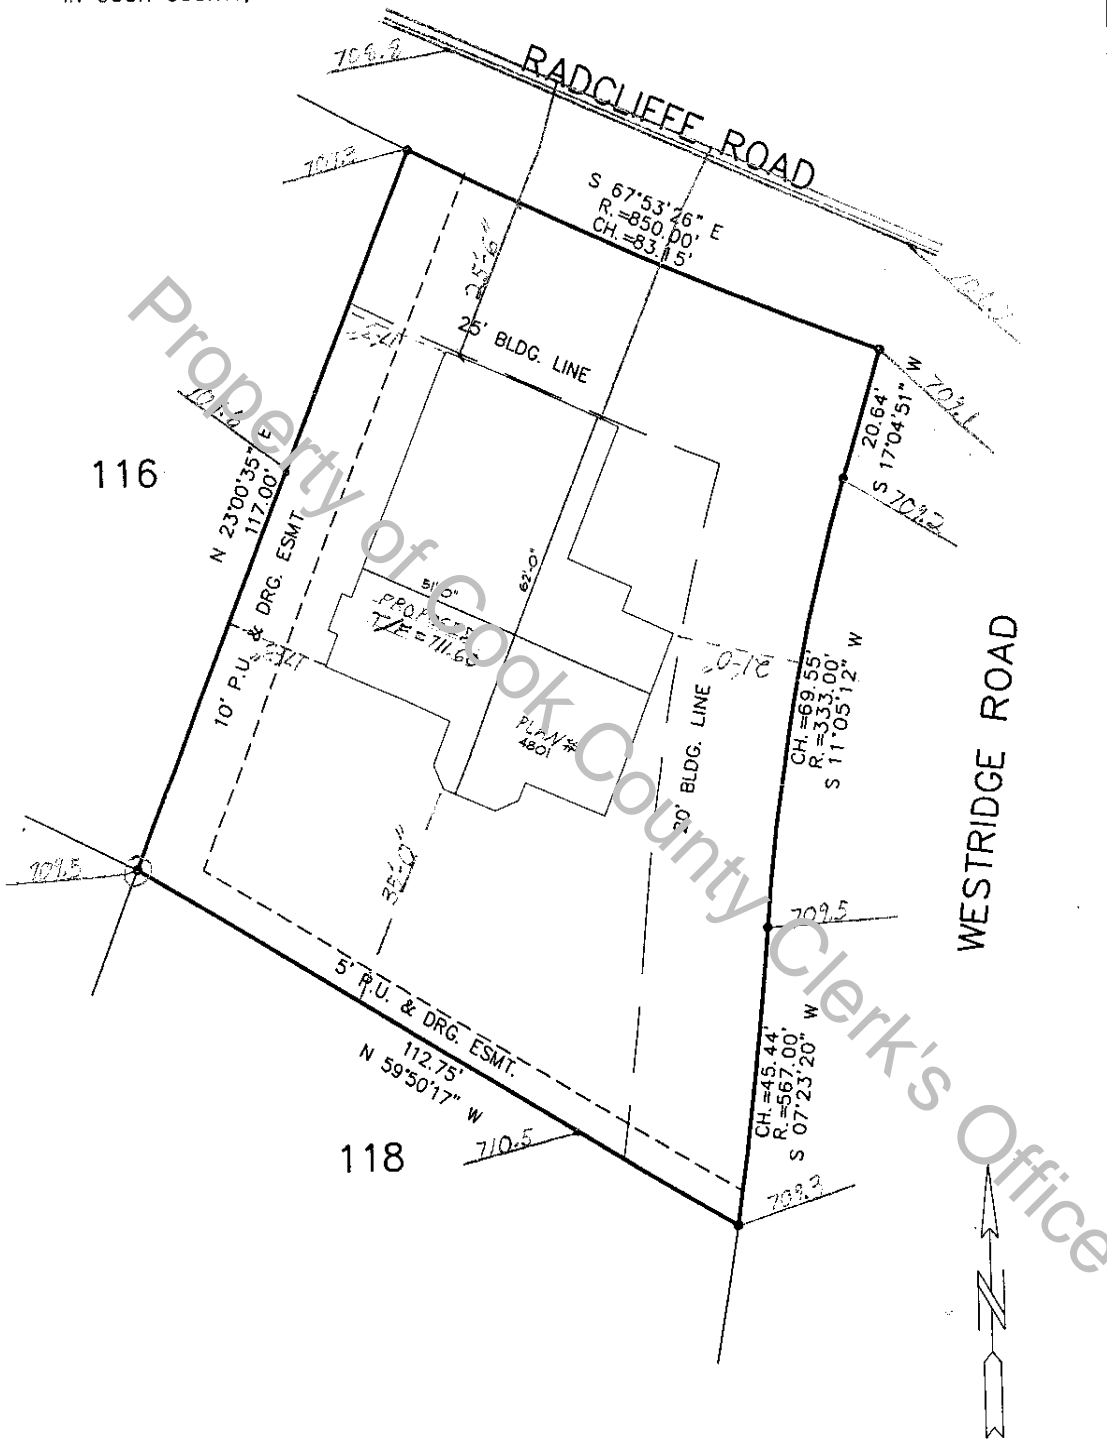

WESTRIDGE ROAD

SCALE: 1"=20'

STATE OF ILLINOIS)
 COUNTY OF WILL)
 I, ROBERT A. ROGINA, ILLINOIS PROFESSIONAL LAND SURVEYOR NO. 2017, DO HEREBY CERTIFY THAT I HAVE SURVEYED THE PROPERTY DESCRIBED IN THE ABOVE CAPTION AND THAT THIS PLAT OF SURVEY IS A CORRECT REPRESENTATION THEREOF

DATED THIS _____ DAY OF _____ 2000

ROBERT A. ROGINA

COMPARE DESCRIPTION AND POINTS BEFORE BUILDING AND REPORT ANY APPARENT DIFFERENCE TO THE SURVEYOR. REFER TO DEED OR GUARANTEE TITLE POLICY FOR BUILDING LINE RESTRICTIONS OR EASEMENTS NOT SHOWN ON PLAT OF SURVEY. TO INSURE AUTHENTICITY OF ANY COPIES, THEY MUST BEAR THE SURVEYOR'S IMPRESSED SEAL.

LOT 117 RADCLIFFE PLACE UNIT 4			
SCALE: 1"=20'	DATE: 11/11/00	REVISED: 2/5/01	DRAWN BY: CMC
ROGINA & ASSOCIATES, LTD. ENGINEERS • SURVEYORS • PLANNERS			
93 Caterpillar Drive Joliet, Illinois 815/729-0777 FAX 815/729-0782			
GALLAGHER & HENRY			FILE NO: 0505.19


P

UNOFFICIAL COPY

9945
510
1950
1903

14,308
- 3,162
- 750
- 1240

9136 116
1015

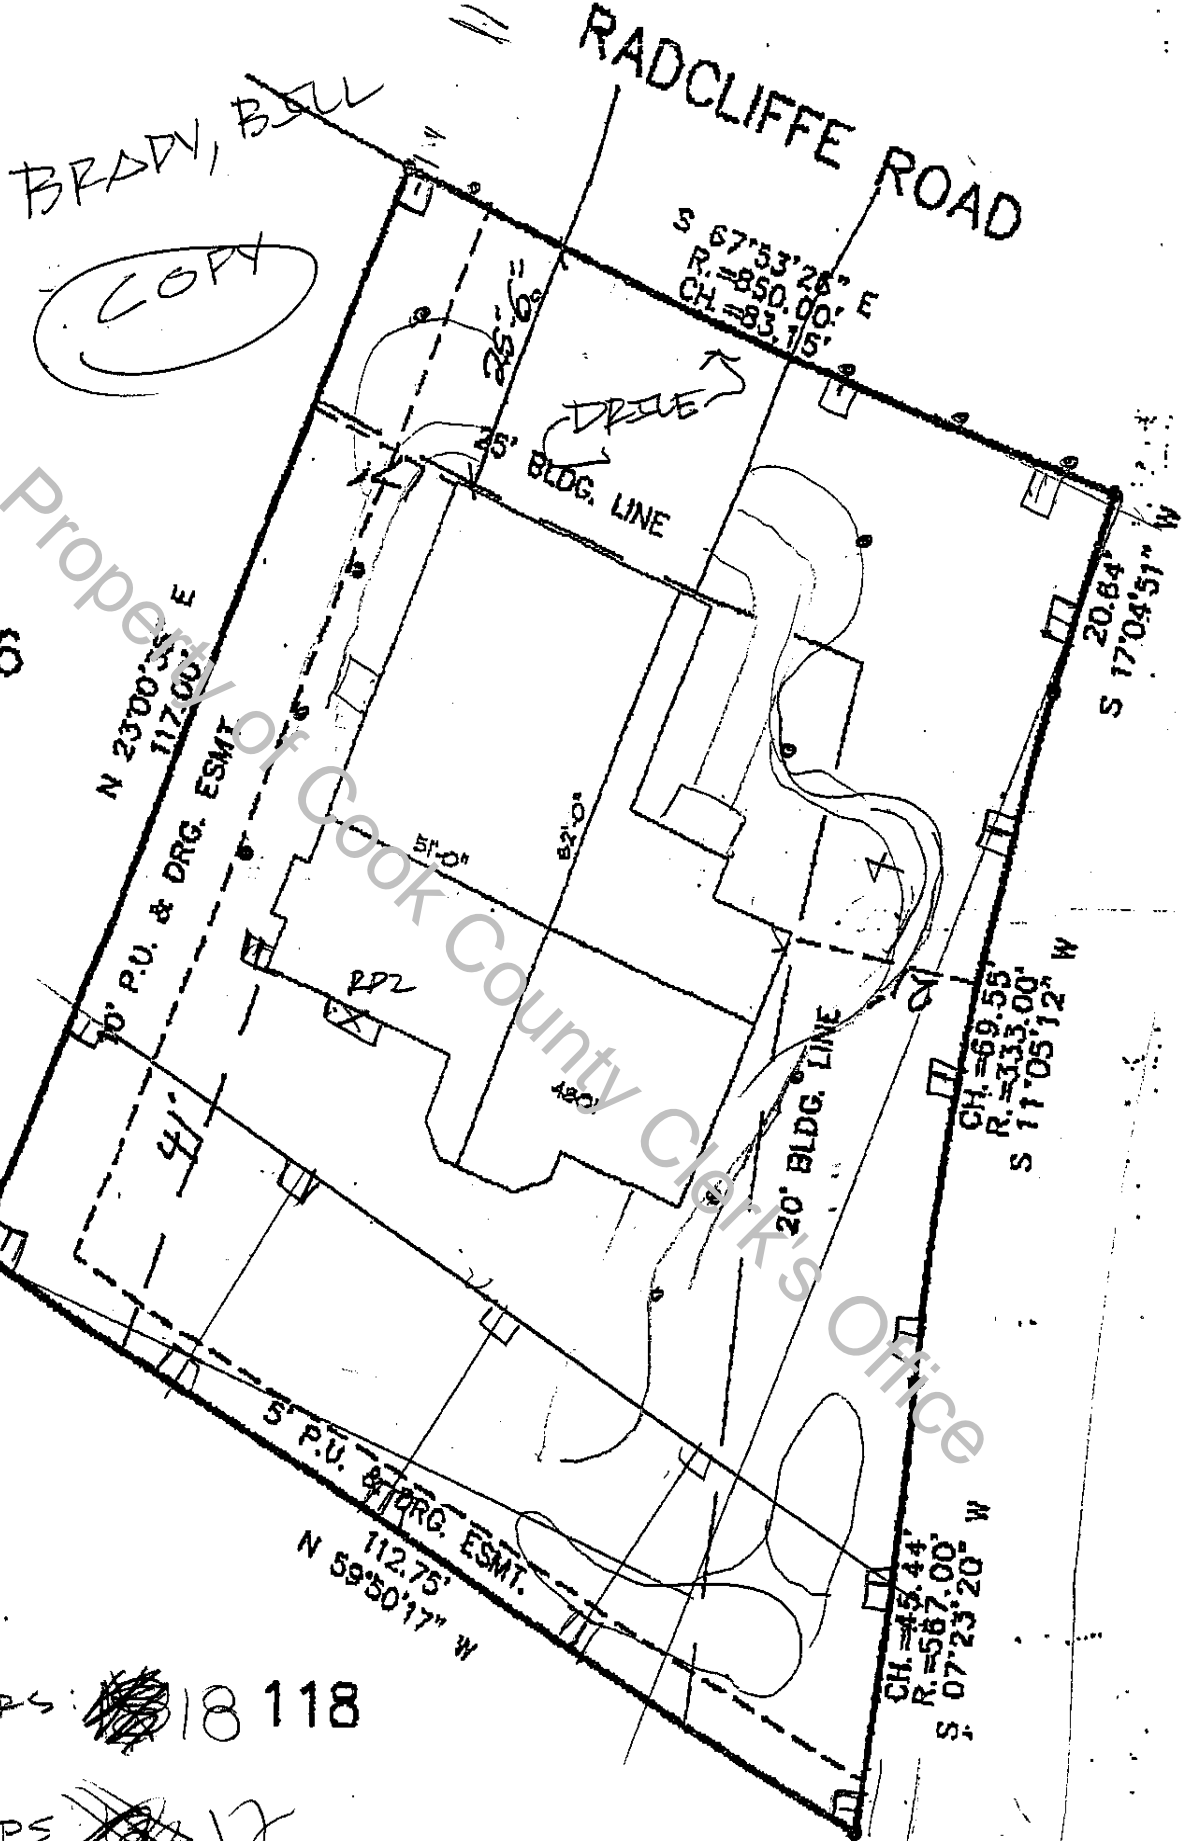

ROTAPS: ~~18~~ 118

POPUPS: ~~12~~

☒ = RPR

2701 Radcliffe Rd
Troy Park, IL 60477