

23 436 306

This Indenture, Made this 10th day of February A. D. 1976 between

LaSalle National Bank

a national banking association, of Chicago, Illinois, as Trustee under the provisions of a deed or deeds in trust, duly recorded and delivered to said Bank in pursuance of a trust agreement dated the 31st day of January 1974, and known as Trust Number 45544, party of the first part, and ROGER T. BRYANT (Divorced and not since remarried) party of the second part. (Address of Grantee(s): 157 Highbury Drive, Elgin, Illinois 60120)

Handwritten vertical text: 11-6363647-1

WITNESSETH that said party of the first part, in consideration of the sum of TEN AND NO/100 Dollars, (\$10.00) and other good and valuable considerations in hand paid, does hereby grant, sell and convey unto said party of the second part, the following described real estate, situated in Cook County, Illinois, to wit:

PARCEL I: Lot 93 in Parkwood Village Unit No. 2, being a subdivision of Part of the Northeast Quarter of Section 18, Township 41 North, Range 9 East of the Third Principal Meridian in the City of Elgin according to the Plat of said Parkwood Village Unit No. 2 recorded October 2, 1974 as Document No. 22865813 in Cook County, Illinois; and

PARCEL II: Easements for the benefit of PARCEL I created by the Declaration of Covenants, Conditions and Restrictions of Parkwood Village recorded October 3, 1974 as Document No. 22866213 in the records of Cook County, Illinois and by Supplement No. One to Declaration of Covenants, Conditions and Restrictions of Parkwood Village recorded October 10, 1974 as Document No. 22873469 in the records of Cook County, Illinois.


SUBJECT TO: General real estate taxes for the year 1976 and subsequent years. Public utility easements. Declaration of Covenants, Conditions and Restrictions of Parkwood Village recorded October 3, 1974 as Document No. 22866213 in the records of Cook County, Illinois and Supplement No. One to Declaration of Covenants, Conditions and Restrictions of Parkwood Village recorded October 10, 1974 as Document No. 22873469 in the records of Cook County, Illinois.

together with the tenements and appurtenances thereunto belonging.

TO HAVE AND TO HOLD the same unto said party of the second part as aforesaid and to the proper use, benefit and behoof of said party of the second part forever.

This deed is executed pursuant to and in the exercise of the power and authority granted to and vested in said trustee by the terms of said deed or deeds in trust delivered to said trustee in pursuance of the trust agreement above mentioned. This deed is made subject to the lien of every trust deed or mortgage (if any there be) of record in said county affecting the said real estate or any part thereof given to secure the payment of money and remaining unreleased at the date of the delivery hereof.

IN WITNESS WHEREOF, said party of the first part has caused its corporate seal to be hereunto affixed, and has caused its name to be signed to these presents by its Assistant Vice-President and attested by its Assistant Secretary, the day and year first above written.

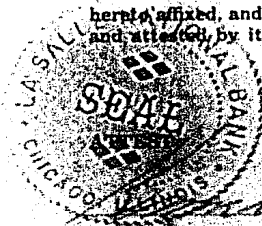

LaSalle National Bank

as Trustee as aforesaid,

By [Signature] Assistant Vice-President

THE ASSISTANT VICE PRESIDENT  
TERESA J. ROYAN, ASST. VICE PRES.  
U. S. DEPT. OF JUSTICE  
201 E. CHURCH AVE.  
CHICAGO, ILL. 60601

Assistant Secretary

Handwritten vertical text: 23 436 306

# UNOFFICIAL COPY

## PLAT OF SURVEY

Of Lot 93 in Parkwood Village Unit No.2, being a Subdivision of part of the Northeast Quarter of Section 18, Township 41 North, Range 9 East of the Third Principal Meridian in the City of Elgin, according to the plat of said Parkwood Village Unit No.2, recorded October 2, 1974 as Document No. 22865813, in Cook County, Illinois.

STATE OF ILLINOIS ) SS  
COUNTY OF KANE )


APR 1 1976

This is to certify that the plat hereon drawn correctly shows the location of the improvements upon the above described property and that there are no encroachments or easements except as indicated hereon or as described by the Declaration of Covenants, Conditions and Restrictions of Parkwood Village recorded October 3, 1974 as Document No. 22866213 in the records of Cook County, Illinois.

W.A. RAXOW AND ASSOCIATES, LTD.

*Richard E. Bailey*  
Illinois Land Surveyor No. 1692  
December 18, 1974

23 436 306

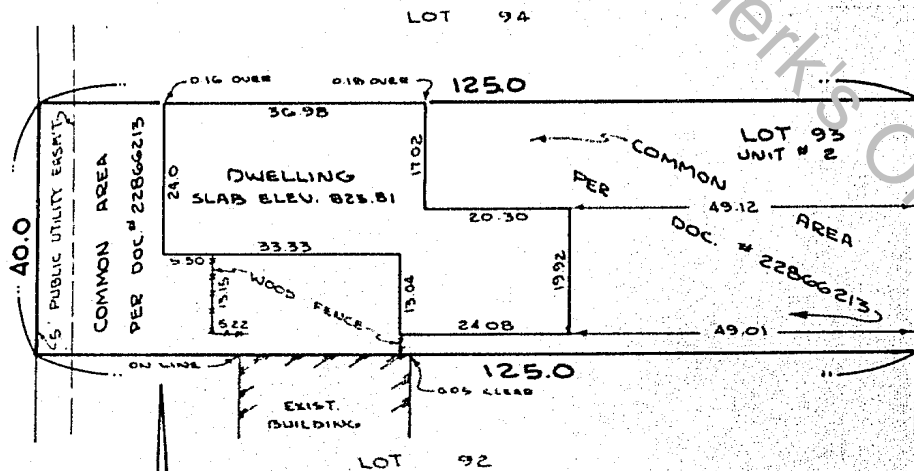

SCALE: 1" = 20'  
DIMENSIONS IN FEET & DECIMALS

W. A. RAXOW & ASSOCIATES, LTD.  
MUNICIPAL & CIVIL ENGINEERS  
106 N. State Street  
Elgin, Illinois 60120

# UNOFFICIAL COPY

RECORDS OF DEEDS  
COOK COUNTY ILLINOIS

1976 APR 1 AM 10 54  
APR-1 -76 165411 • 23436306 - A - Rec 11.15

STATE OF ILLINOIS, }  
COUNTY OF COOK, } ss:

I, Jody Pasternak a Notary Public in and for said County,  
in the State aforesaid, DO HEREBY CERTIFY that James A. Clark

Assistant Vice-President of LA SALLE NATIONAL BANK, and KENNETH MARKS  
Assistant Secretary thereof, personally known to me to be the same persons whose names are sub-  
scribed to the foregoing instrument as such Assistant Vice President and Assistant Secretary res-  
pectively, appeared before me this day in person and acknowledged that they signed and delivered  
the said instrument as their own free and voluntary act, and as the free and voluntary act of said  
Bank, for the uses and purposes therein set forth; and the said Assistant Secretary did also then and  
there acknowledge that he as custodian of the corporate seal of said Bank did affix the said corporate  
seal of said Bank to said instrument as his own free and voluntary act, and as the free and voluntary  
act of said Bank for the uses and purposes therein set forth.

GIVEN under my hand and Notarial Seal this 11th day of April

*Jody Pasternak*  
NOTARY PUBLIC  
My Commission Expires on August 29, 1976

STATE OF ILLINOIS  
REAL STATE TRANSFER TAX  
DEPT OF REVENUE  
\$ 30.00  
CHICAGO, ILLINOIS

23436306

MAIL

Box No. ....  
**Trustee's Deed**

~~LaSalle National Bank~~  
TRANSFER  
100

MAIL TO:  
ROGER T. BRYANT  
157 HIGHBURY DRIVE  
ELGIN, ILLINOIS

~~LaSalle National Bank~~  
185 South LaSalle Street  
CHICAGO  
032-A CP